




# 12275 El Camino Real

As-built | Suite 175 | 5,828 r.s.f. | Available 7/1/18

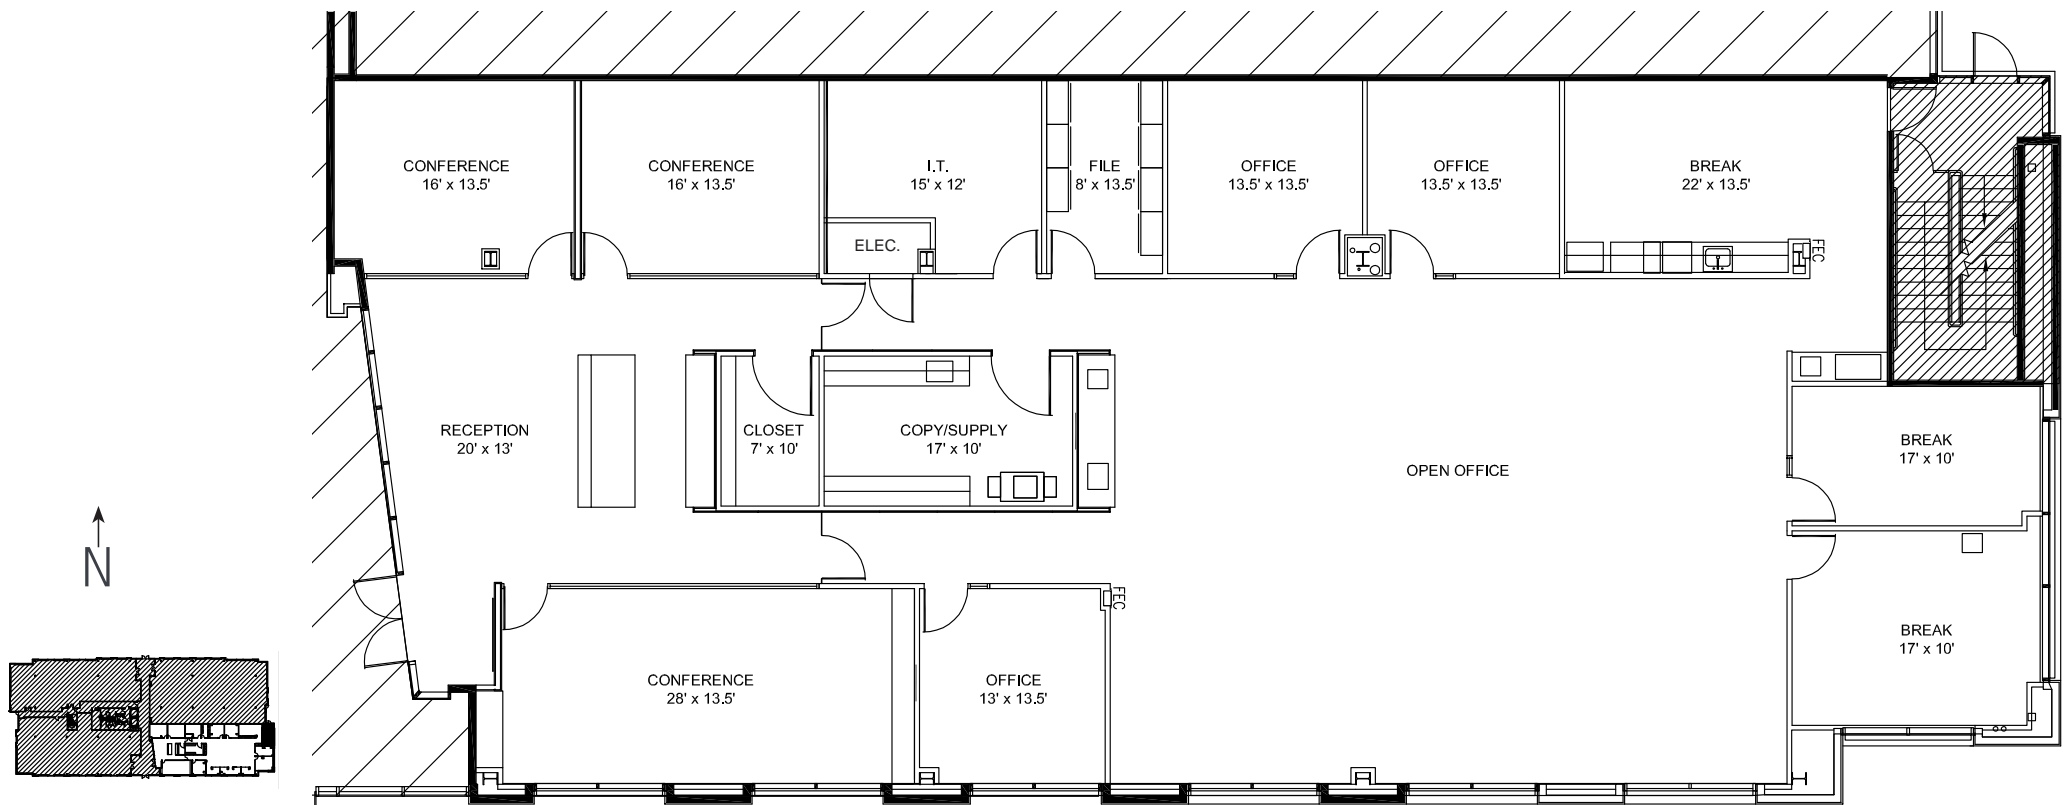

\*room sizes are approximate



Tony Russell  
tony.russell@am.jll.com  
858.410.1213  
Lic. No. 01275372

Bess Wakeman  
bess.wakeman@am.jll.com  
858.410.1245  
Lic. No. 01177659

