




# 12265 El Camino Real

As-Built | Suite 200 | 14,670 r.s.f.  
Suite 220 | 3,678 r.s.f.

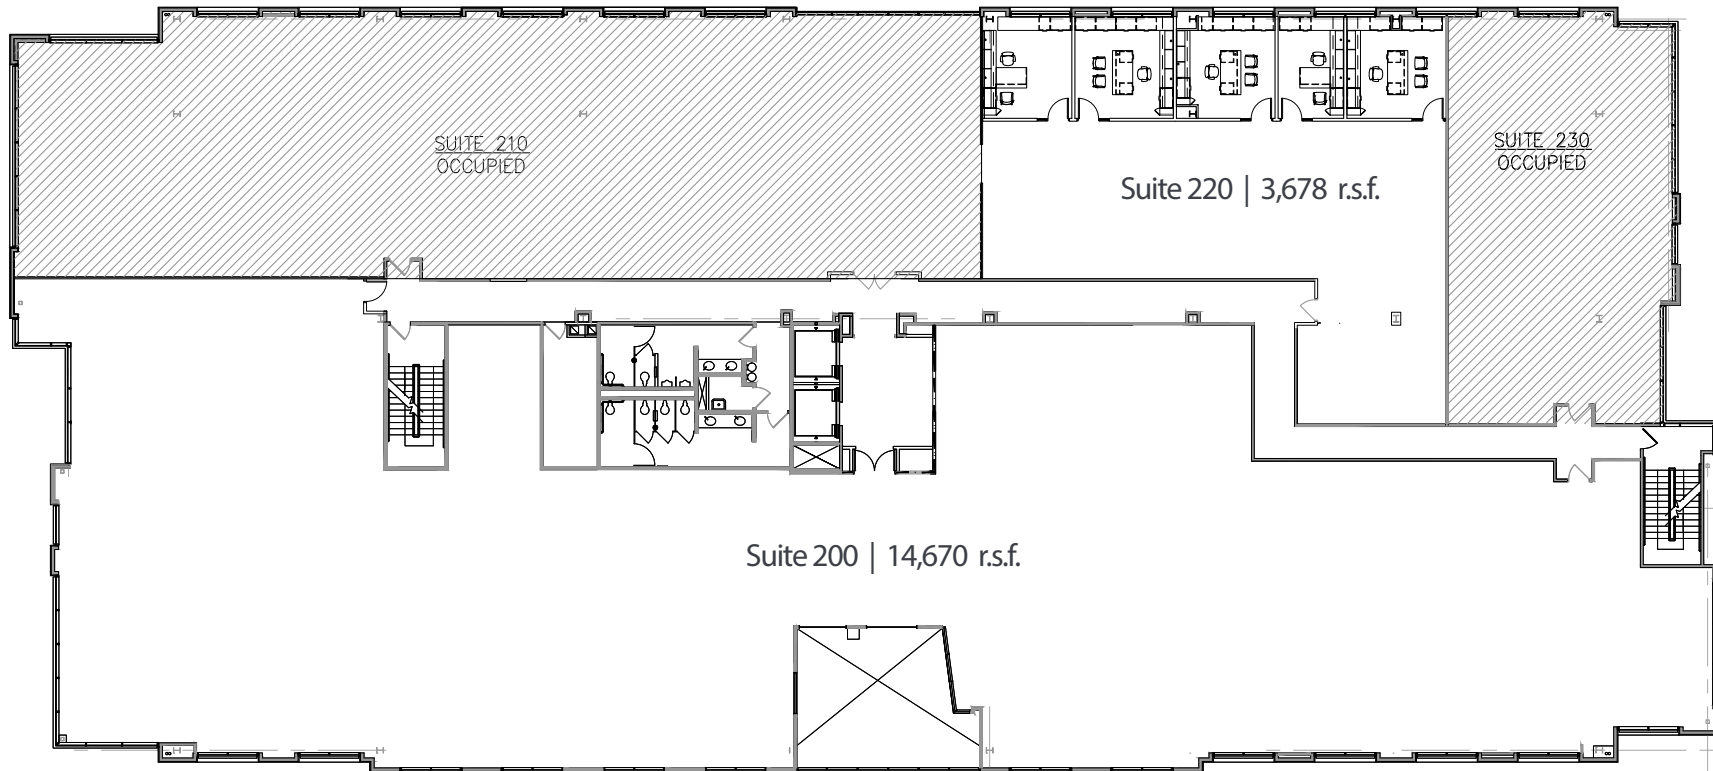

Tony Russell  
tony.russell@am,jll.com  
858.410.1213  
Lic. No. 01275372

Bess Wakeman  
bess.wakeman@am,jll.com  
858.410.1245  
Lic. No. 01177659



**PASEO**  
DEL MAR